



AS-BUILT PLAN

THE STONEHORSE


DEEP HOI



Date: 11-05-2023
Scale: 1" = 30'
Project No.: H-2891-85.0
Sheet No.: 1 of 1

Rev. #	Description of Revision	Date

Terry W. Eldredge, L.S.
9 Old Corners Road, Chatham MA
(774) 822-0386; terry.w.eldredge@gmail.com

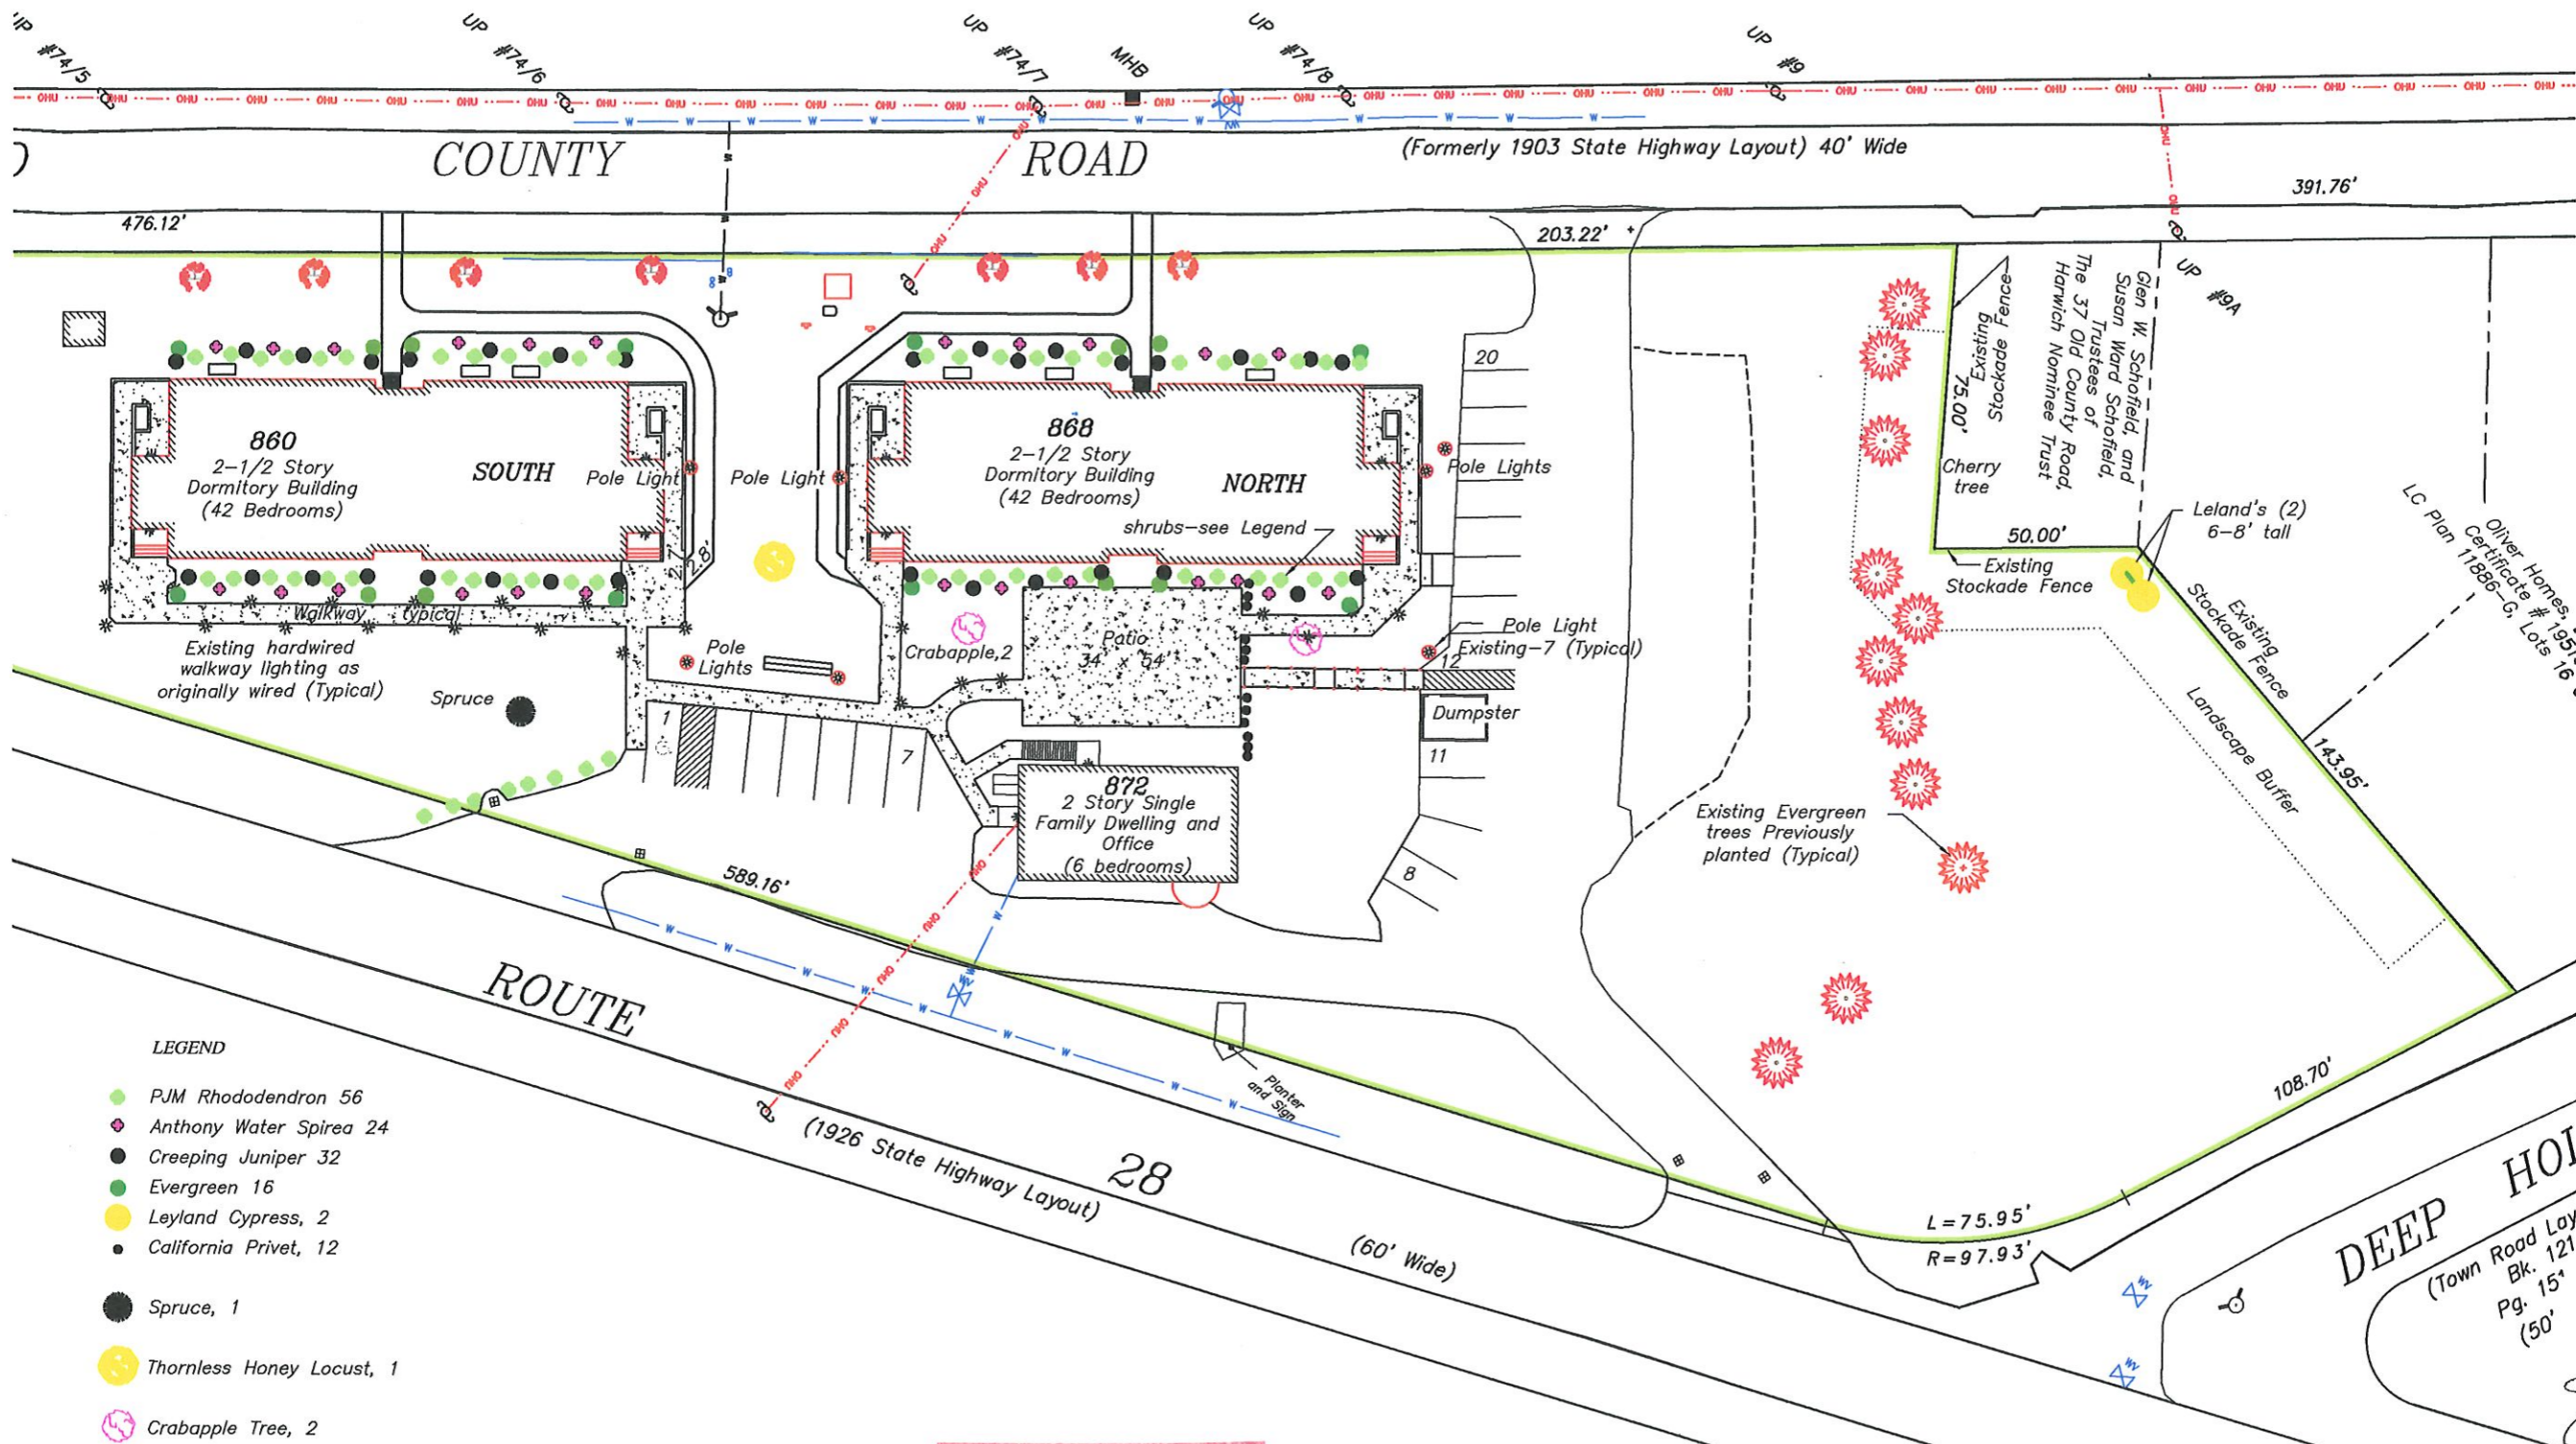

- LEGEND
- PJM Rhododendron 56
 - ◆ Anthony Water Spirea 24
 - Creeping Juniper 32
 - Evergreen 16
 - Leyland Cypress, 2
 - California Privet, 12
 - Spruce, 1
 - Thornless Honey Locust, 1
 - Crabapple Tree, 2
 - Red Sunset Maple, 1
 - TOTAL SHRUBS and TREES 147
 - Deciduous Trees Previously Planted
 - Evergreen Trees Previously Planted

RECEIVED
NOV 07 2023
By _____

