


Lot # 9
REAR

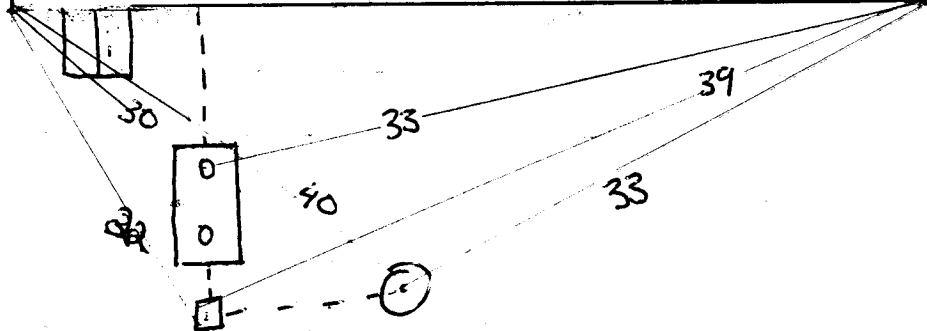

TOWN of HARWICH

Location Lot 9 Christobeth Dr. Sewage Permit No. 96-20

Village East Harwich

Installer's Name & Address Balizes Septic

Builder or Owner Davenport Realty

Date Permit Issued 1/18/96 Date Compliance Issued 6/24/96 ~~11/8/96~~