


Lot #8
REAR

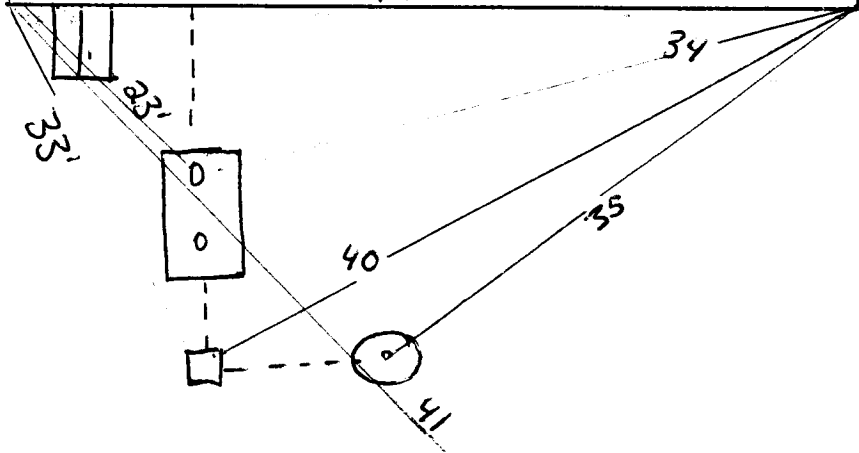

TOWN of HARWICH

Location Lot 8 # Christybeth Dr. Sewage Permit No. 96-21

Village East Harwich

Installer's Name & Address Daluzes Septic

Builder or Owner Davenport Realty

Date Permit Issued 1/18/96 Date Compliance Issued 6/24/96 1483