


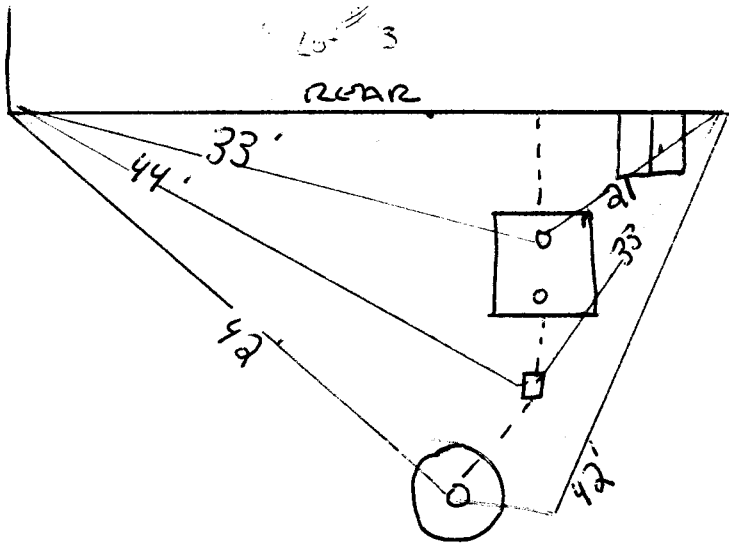

TOWN of HARWICH

Lot #13

Location Chris Tobeth Circle Sewage Permit No. 96-27

Village Harwich

Installer's Name & Address ~~Harwich~~ Realty

Daluz's Septic

Builder or Owner Davenport Realty

Date Permit Issued 1/19/96 Date Compliance Issued 6/24/96 1188