


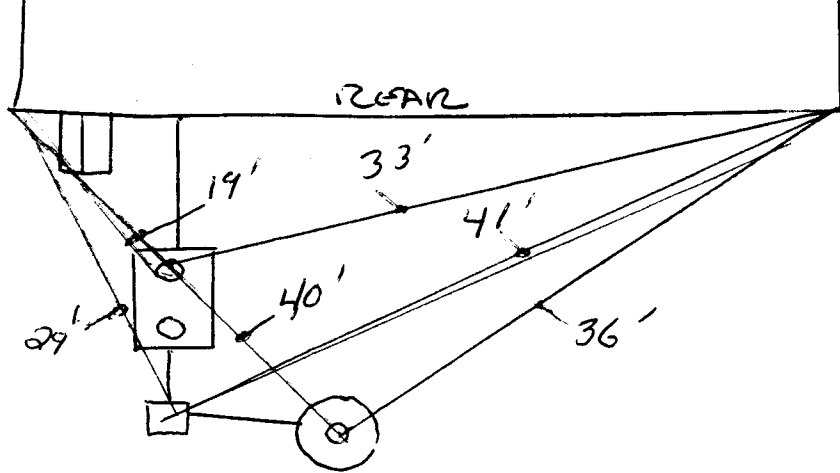

TOWN of HARWICH

Location lot 3 Chrissybeth Dr. **Sewage Permit No.** 96-16
Village East Harwich

Installer's Name & Address Daluzes Septic

Builder or Owner Davenport Realty

Date Permit Issued 1/16/96 **Date Compliance Issued** 6/24/96 HBS