


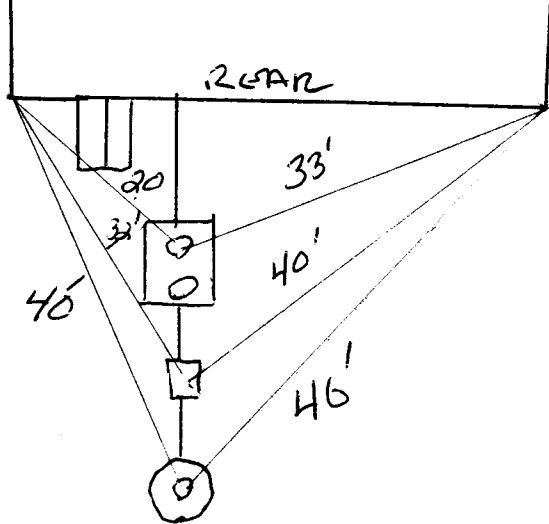

TOWN of HARWICH

Location Lot 1 Chas. J. Leth Dr.
Village East Harwich
Sewage Permit No. 96-15

Installer's Name & Address Daluge's Septic

Builder or Owner Davenport Realty

Date Permit Issued 1/16/96
Date Compliance Issued 4/4/96
1183