


Lot # 11

REAR

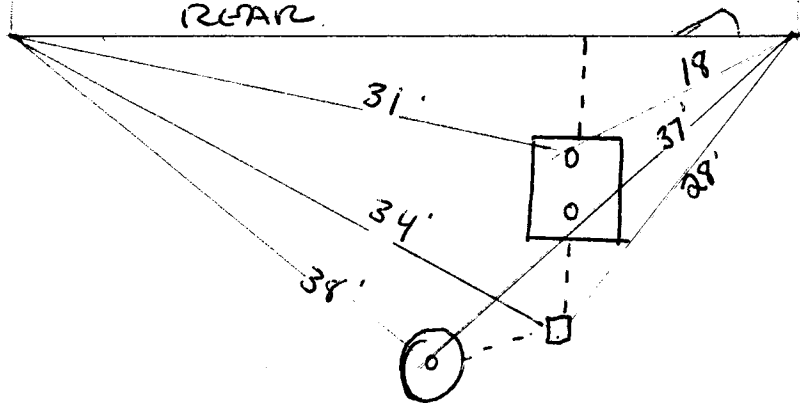

TOWN of HARWICH

Lot # 11

Location Christo Beth Circle Sewage Permit No. 96-23

Village Harwich of Rt 137

Installer's Name & Address Daluzes's Septic

Builder or Owner Davenport Realty

Date Permit Issued 1/18/96 Date Compliance Issued 6/24/96

1188