


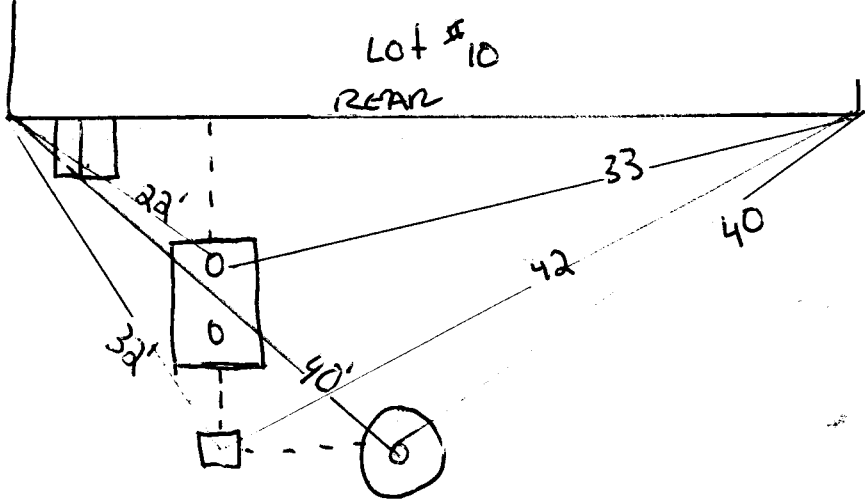

Lot # 10

TOWN of HARWICH

Location Christobeth Circle Sewage Permit No. 96-19

Village Harwich of Pt 137

Installer's Name & Address Daluzes Septic

Builder or Owner Davenport Realty

Date Permit Issued 1/18/96 Date Compliance Issued 6/24/96

1488