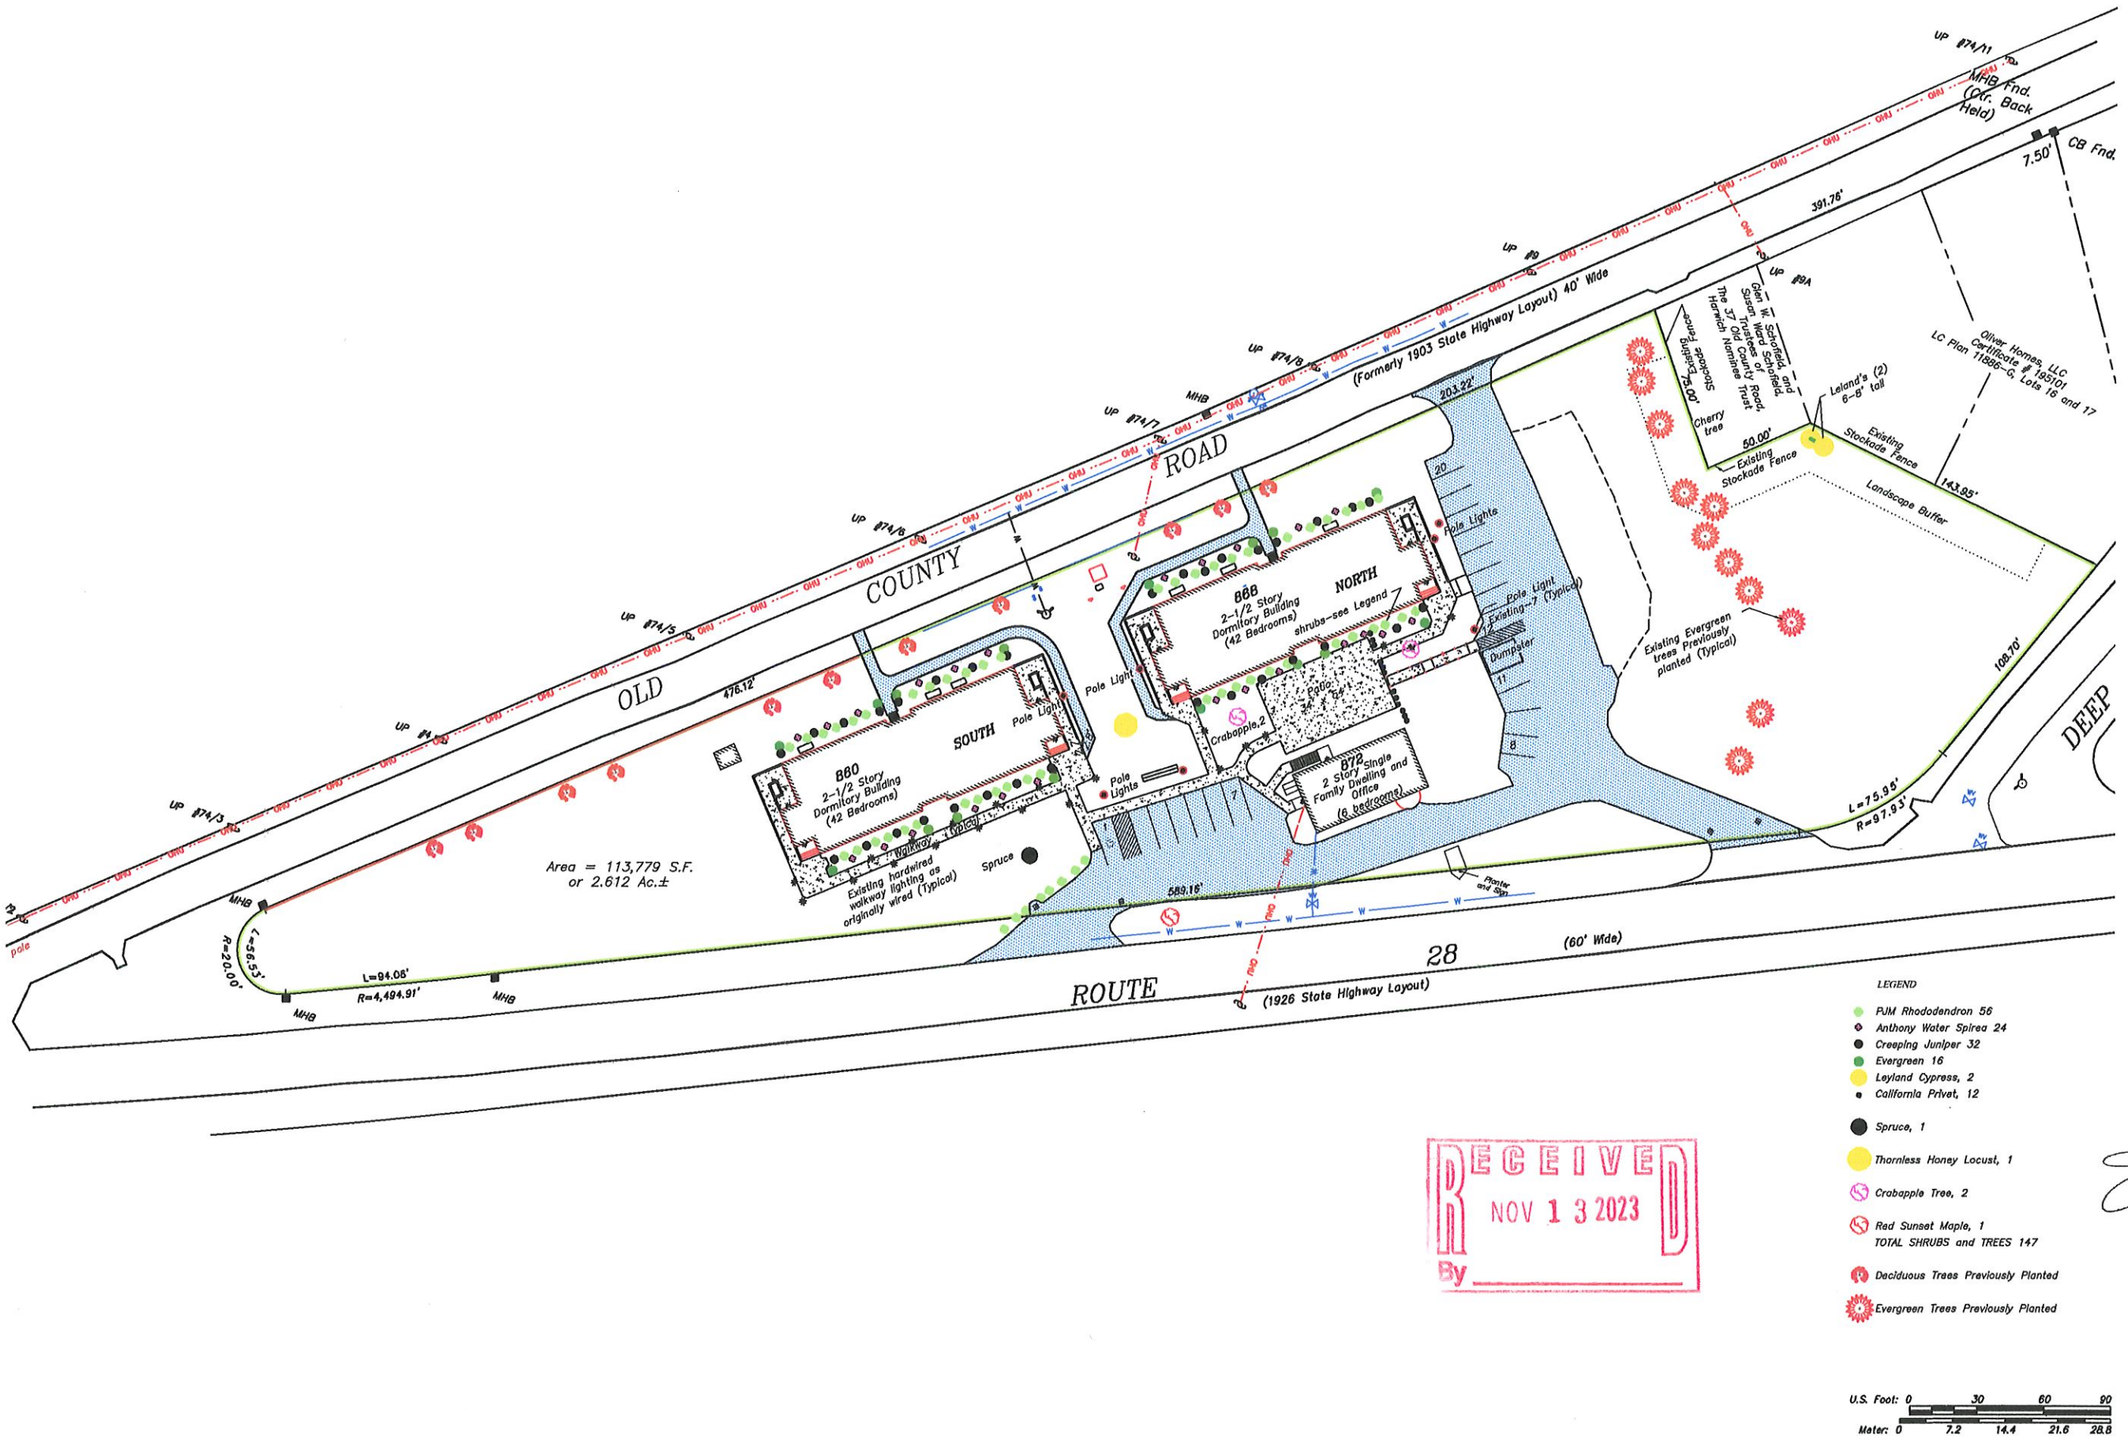

RECEIVED
NOV 13 2023
By

C:\Users\15087\OneDrive\Desktop\Clients Projects\RR Stonehorse\As-Built Plan 2023-11-09 with screen rotated.dwg

AS-BUILT PLAN

Rev. #	Description of Revision	Date
1	Rotated Screen to include the entire subject property	2023-11-09

THE STONEHORSE

Terry W. Eldredge, L.S.
9 Old Comers Road, Chatham MA
(774) 822-0386; terry.w.eldredge@gmail.com

TERRY WAYNE ELDREDGE No. 30320 REGISTERED PROFESSIONAL LAND SURVEYOR

Date: 11-05-2023
Scale: 1" = 30'
Project No.: H-2891-85.0
Sheet No.: 1 of 1